

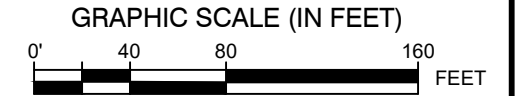


Location: LINCOLN ELEMENTARY SCHOOL

CITY OF OAKLAND
TRAFFIC ENGINEERING
WORK ORDER

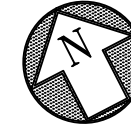

Please Perform the Work Indicated Below:

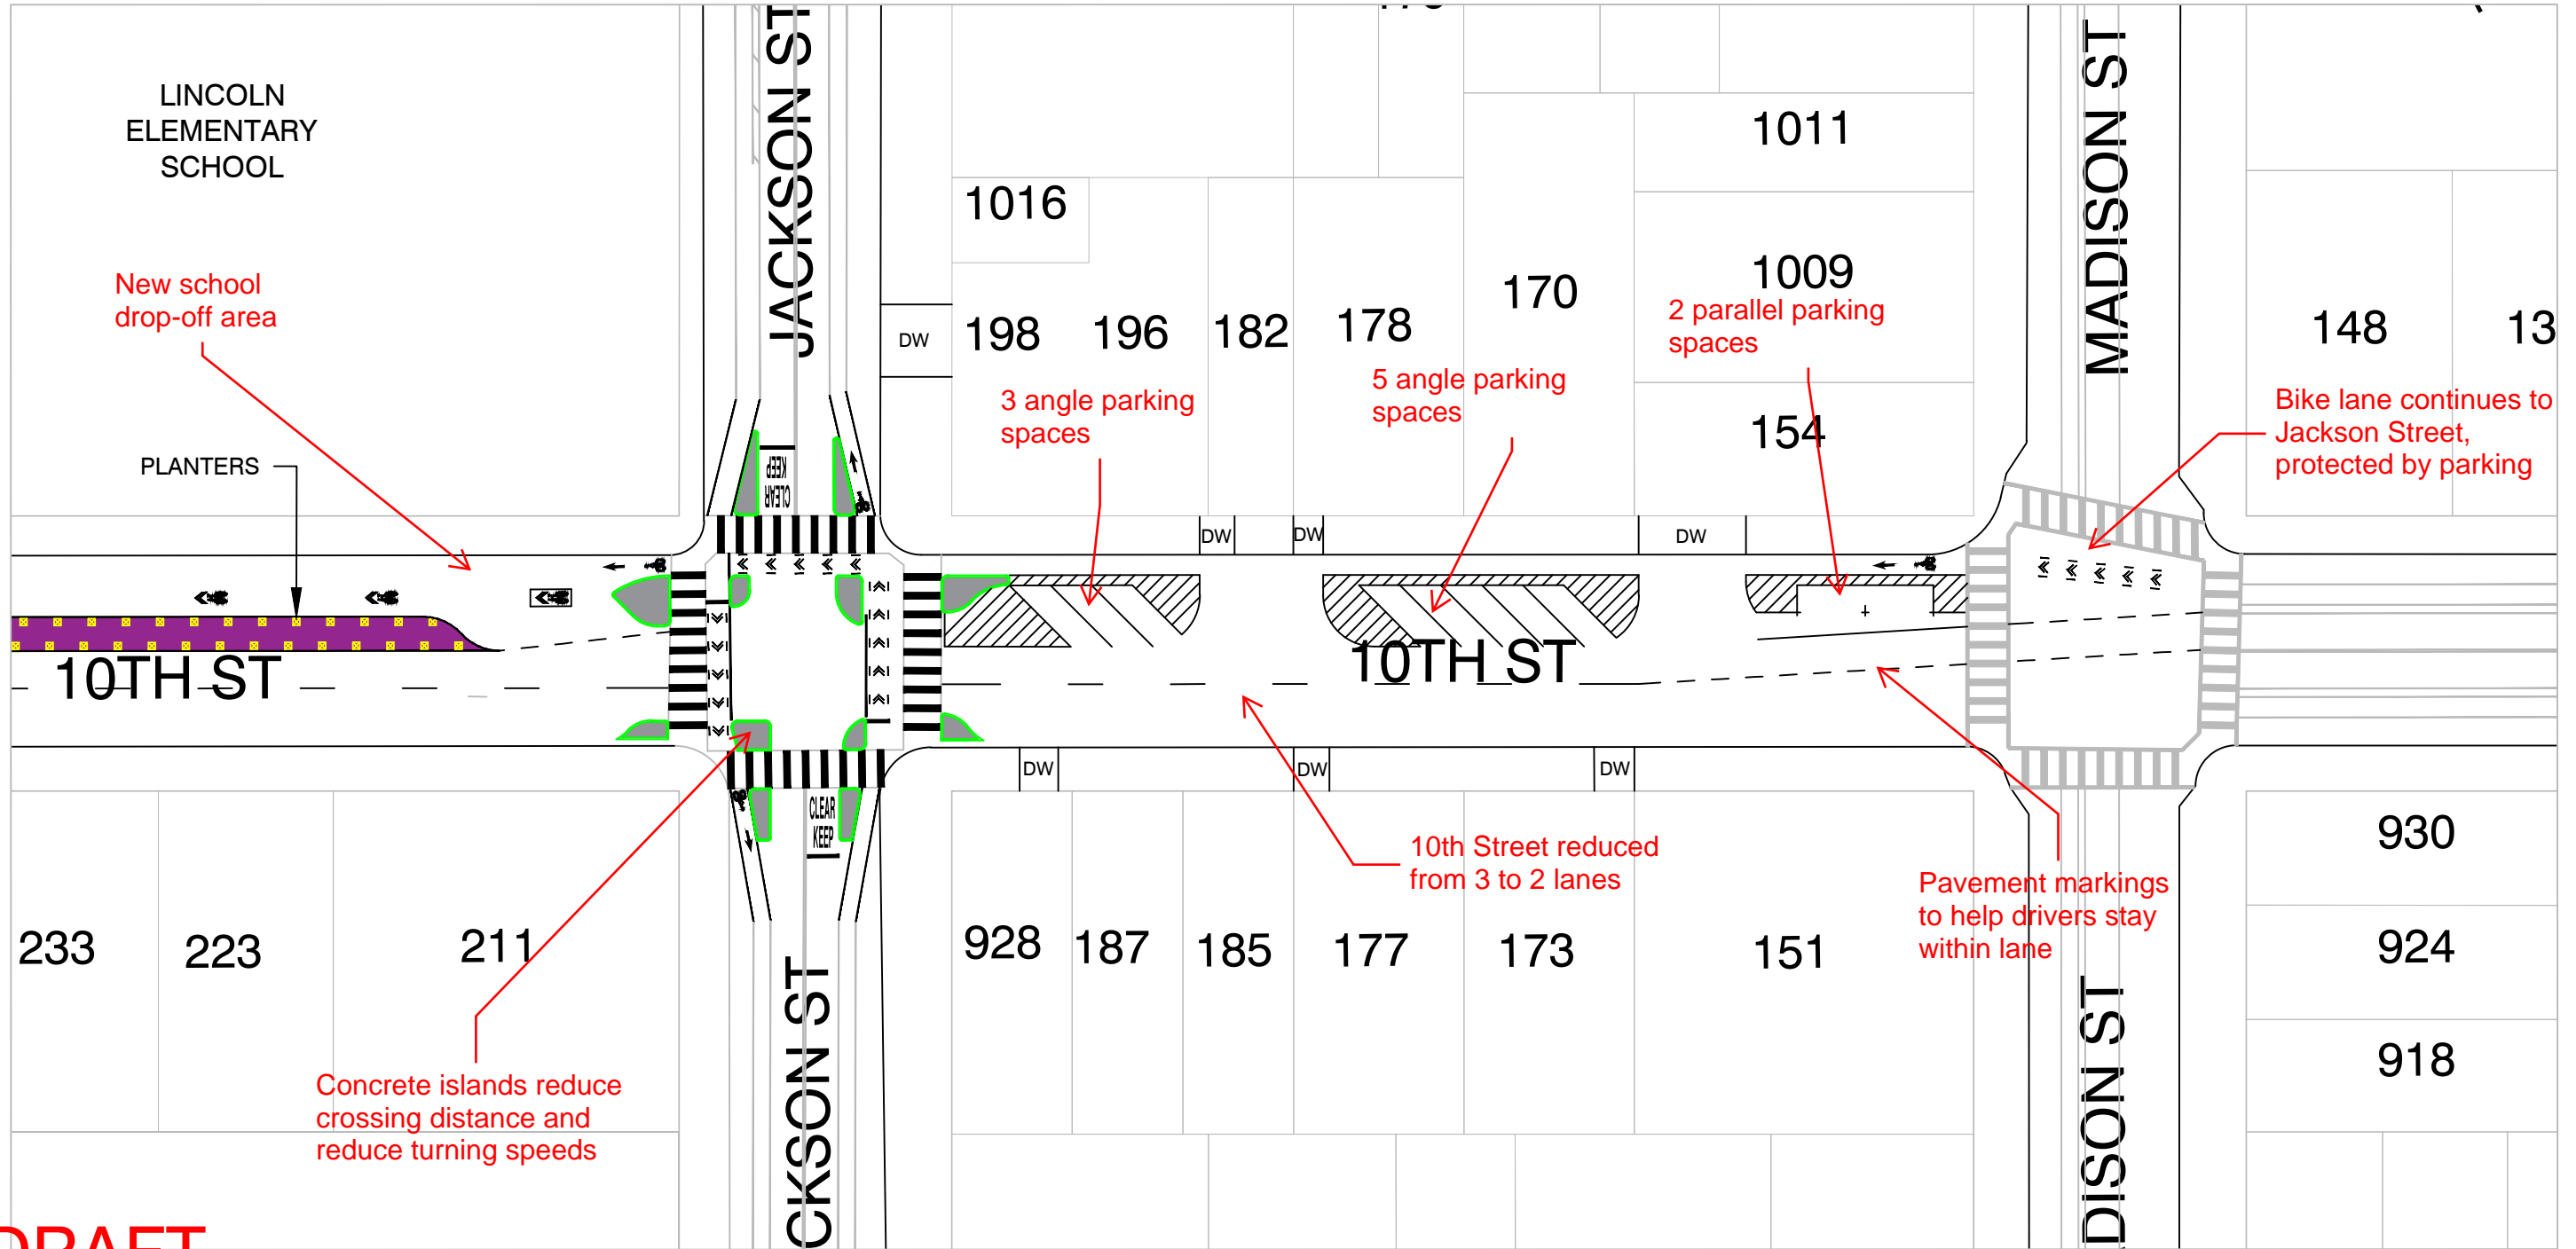

DRAFT



CITY OF OAKLAND
DEPARTMENT OF TRANSPORTATION - SAFE STREETS DIVISION
TRAFFIC ENGINEERING
250 FRANK H. OGAWA PLAZA, SUITE 4344
OAKLAND CA, 94612

ALAMEDA COUNTY SAFE ROUTES TO SCHOOL
LINCOLN ELEMENTARY SCHOOL

No.	DATE	BY	REFERENCE
CHECKED BY	JW		
DESIGNED BY	LW		
DRAWN BY	LW		

SCALE: 1"=80'
DATE: MM/DD/YYYY

SHEET 1 OF X